


**Proposed Rathkeale
Local Area Plan
2023-2029**

**Amenity and
Sustainable Transport
Map 3**

**Proposed Material
Alterations**

LEGEND

- Open Space and Recreation
- Existing Cycleways/Walkways
- Proposed Cycleways/Walkways
- Existing Limerick Greenway
- Indicative line of Future Limerick Greenway Extension
- Playground
- Rathkeale LAP Boundary
- Indicative Foynes to Limerick Road (Including Adare Bypass) Project
- Enhanced Connectivity

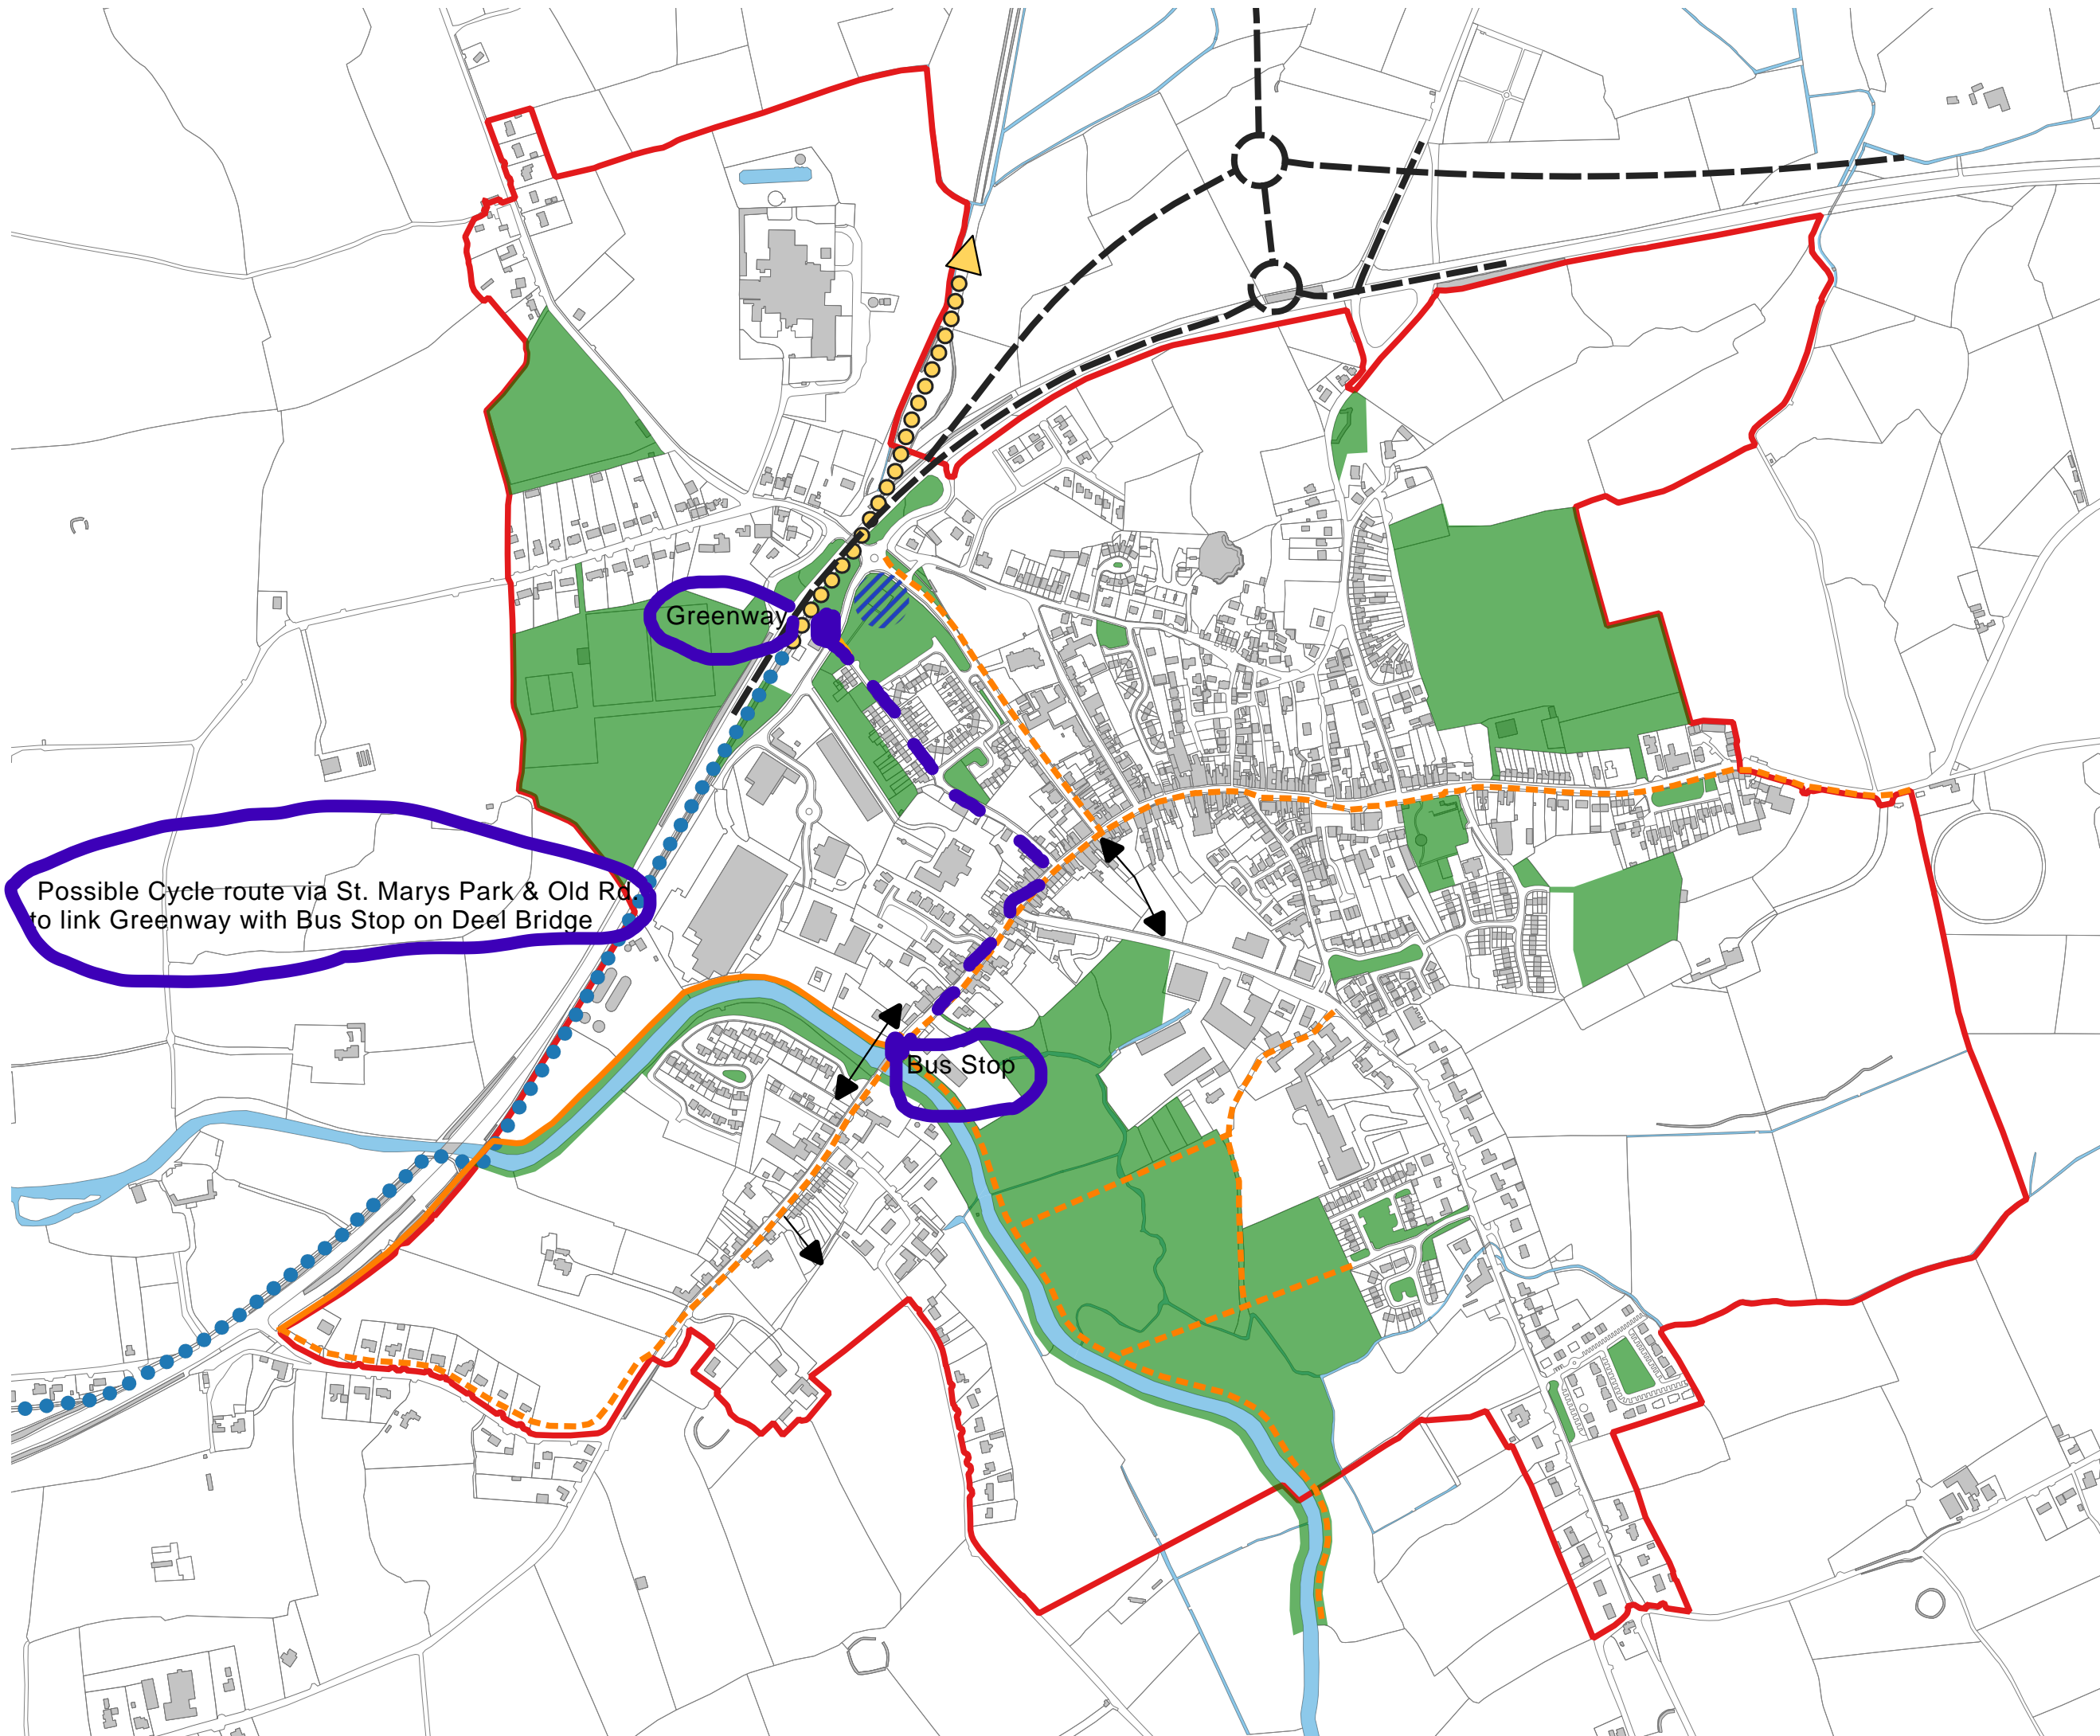

Possible Cycle route via St. Marys Park & Old Rd. to link Greenway with Bus Stop on Deel Bridge

Greenway

Bus Stop

Forward Planning
Economic Development and
Enterprise Directorate

Merchants Quay, Limerick
Tel: (061) 556600
E-mail: forwardplanning@limerick.ie

DATE: November 2022	DWG. NO.: RK/23-29/R14	
DRAWN BY: J. D	CHECKED BY: B. C	SCALE: N/A
OSI LICENCE NO.: © Ordnance Survey Ireland. All rights reserved. Licence No. 2017/09/CCMA/Limerick City & County Council		

